


NO.	DATE	BY	REVISION
1	10/1/77
2
3

MEANING OF SYMBOLS
 1. ...
 2. ...
 3. ...

APPROVED
 STAVIA COUNTY METROPOLITAN COMMISSION
 ...

AS BUILT DRAWING

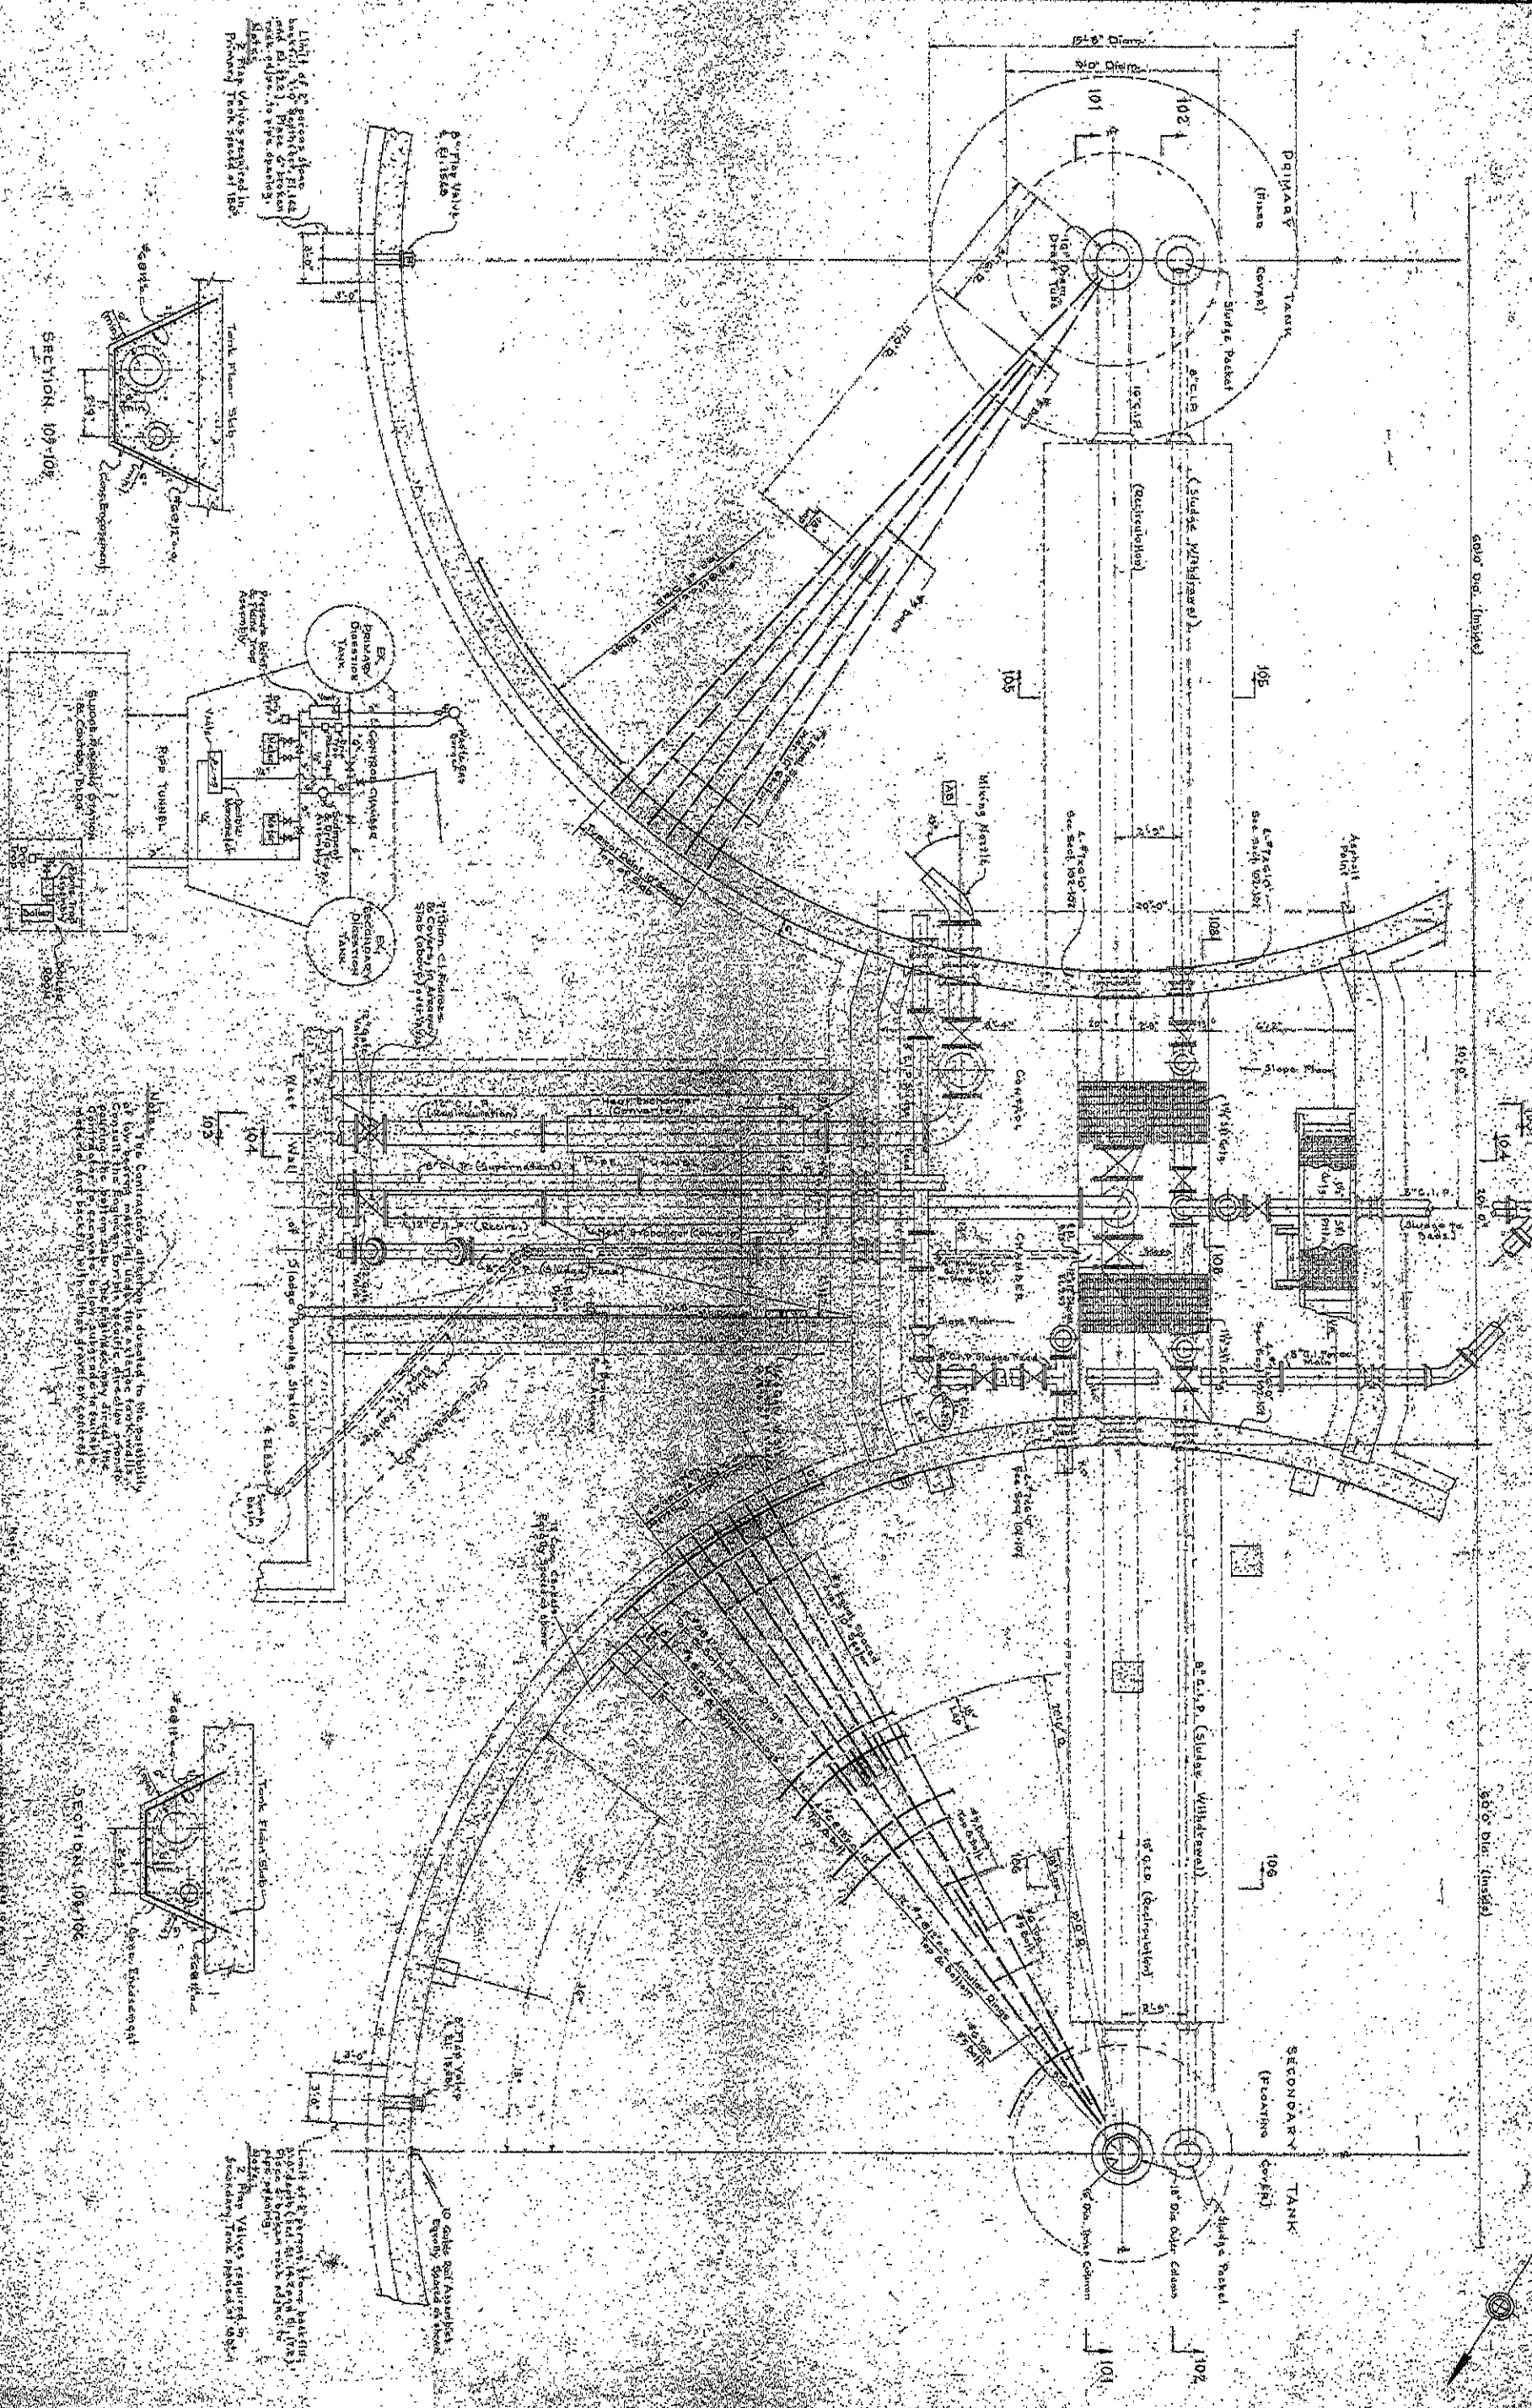

SECTION 109-105

SECTION 108-106

NOTE: The Contractor's attention is directed to the possibility of low bearing material under the existing stone walls. Contact the building for the building, any direct pipe going clear to sewer to allow satisfactory installation of metal and backing with their frame or contact.

List of 22 pieces along bank... (top synthetic filter mat p. 122). Pipe & broken rock (dime to type shown). 2 Pipe Valves required in Secondary Tank space of 105.

